


**ROOF PLAN**  
SCALE 1/8"=1'-0"

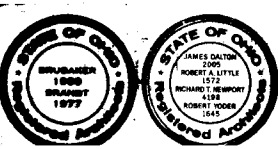

REVISIONS	DATE	ISSUED FOR	DATE
1. APPROXIMATE ITEMS	MAY 1977	ELEVATOR BUILDING	MAY 1977
2. APPROXIMATE	OCT 1977	CONCRETE WORKING	OCT 1977
3. APPROXIMATE	OCT 1977	CONCRETE WORKING	OCT 1977
4. APPROXIMATE	MAY 1977	CONCRETE WORKING	MAY 1977




**DALTON · DALTON · LITTLE**  
**AND**  
**BRUBAKER/BRANDT, INC.**  
ARCHITECTS

KORDA & ASSOCIATES, LTD., STRUCTURAL ENGINEERS  
BARR & NEUMAN, INC., MECHANICAL/ELECTRICAL ENGINEERS

**STATE OFFICE BUILDING AND FACILITIES**  
30-32 EAST BROAD STREET, COLUMBUS, OHIO  
FOR THE  
**OHIO BUILDING AUTHORITY**  
PREPARED FOR  
**STATE OF OHIO**  
DEPARTMENT OF PUBLIC WORKS













DRAWN BY \_\_\_\_\_ DATE \_\_\_\_\_  
CHECKED BY \_\_\_\_\_ DATE \_\_\_\_\_

**A 3 - 19**

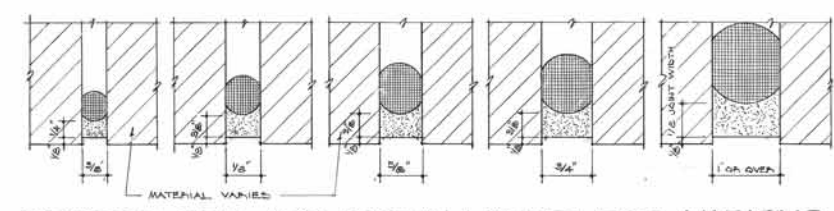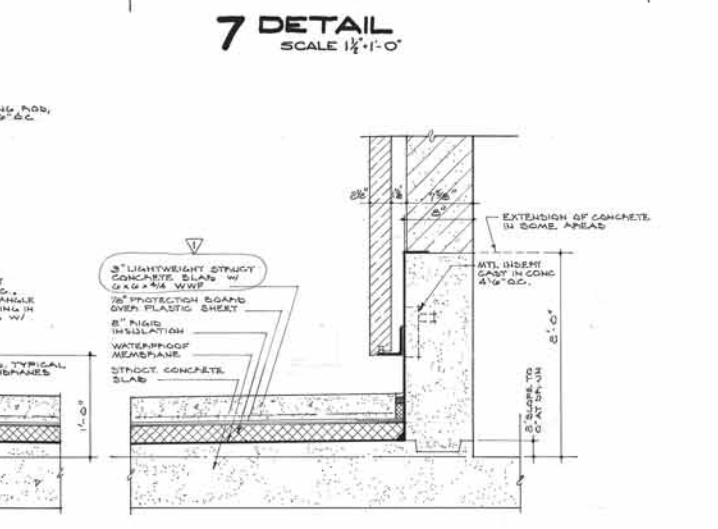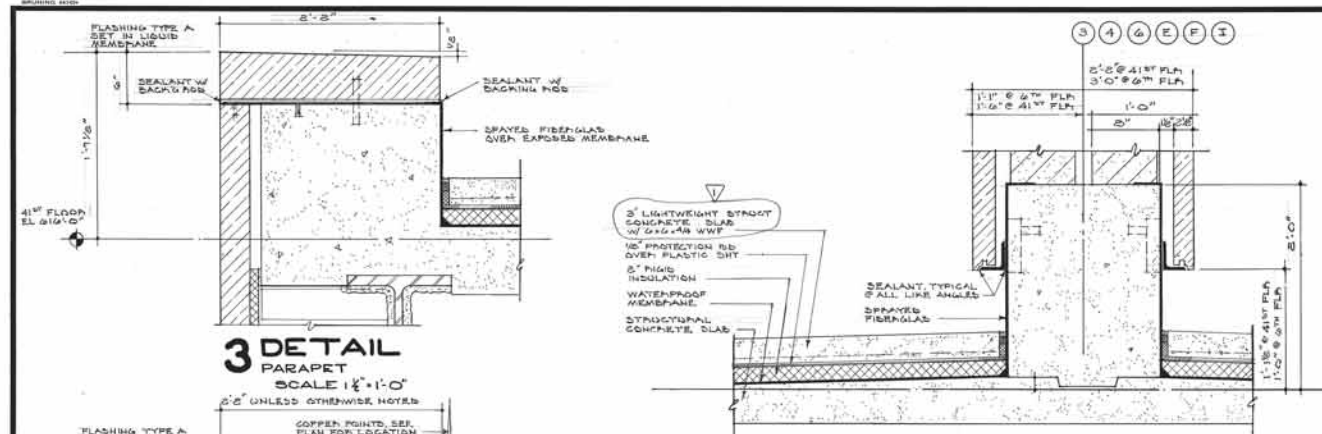

- NOTES:
- SEE SPECIFICATIONS FOR TYPE OF SEALANT TO BE USED AT DIFFERENT LOCATIONS
  - ALL JOINTS 1" IN WIDTH & OVER TO BE LAB UP IN BEADS & TOLERANCE WHERE SELF-LEVELING MATERIAL IS USED
  - ALL JOINTS TO BE PRIMED BEFORE SEALANT IS INSTALLED
  - METAL BOND BREAKING FIBERGLAS WITH FIBER TO PROPER DEPTH, NO SHARP TOOLS PERMITTED

PROPER SEALANT INSTALLMENT FOR VARIOUS WIDTH JOINTS  
FULL SIZE

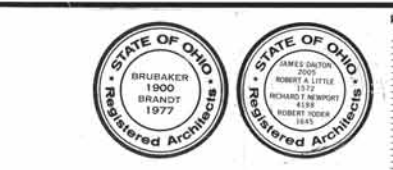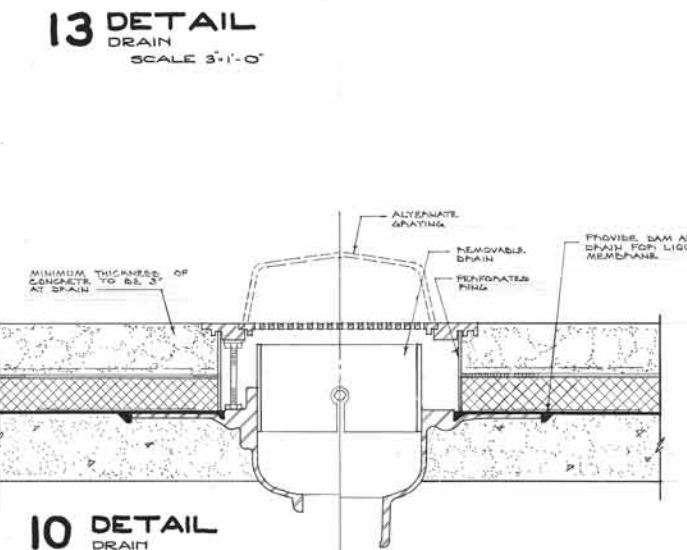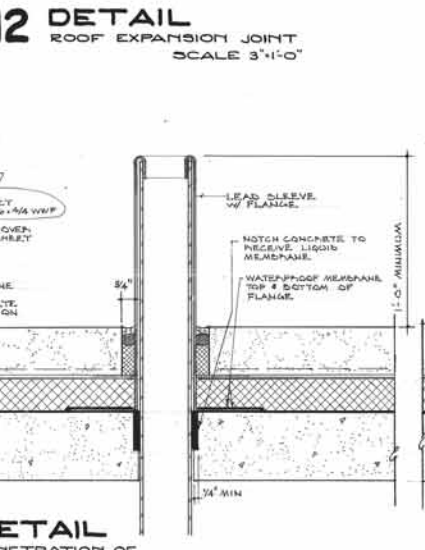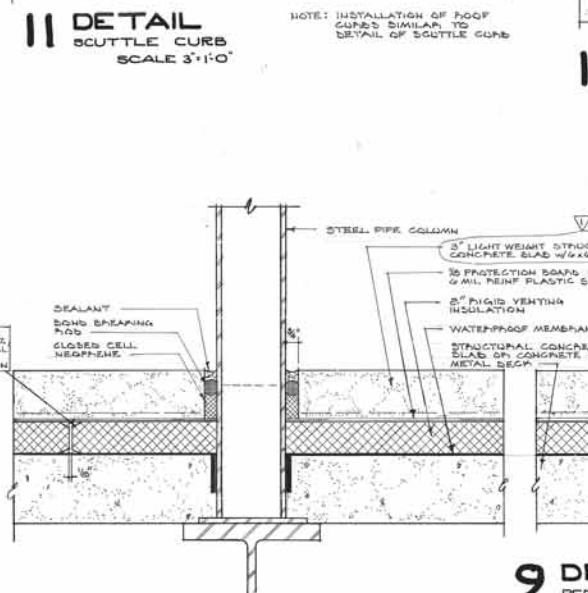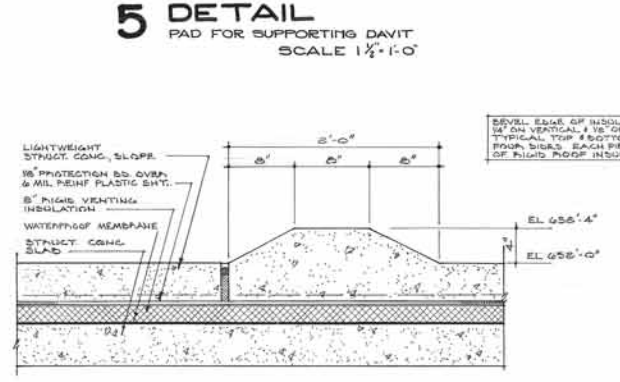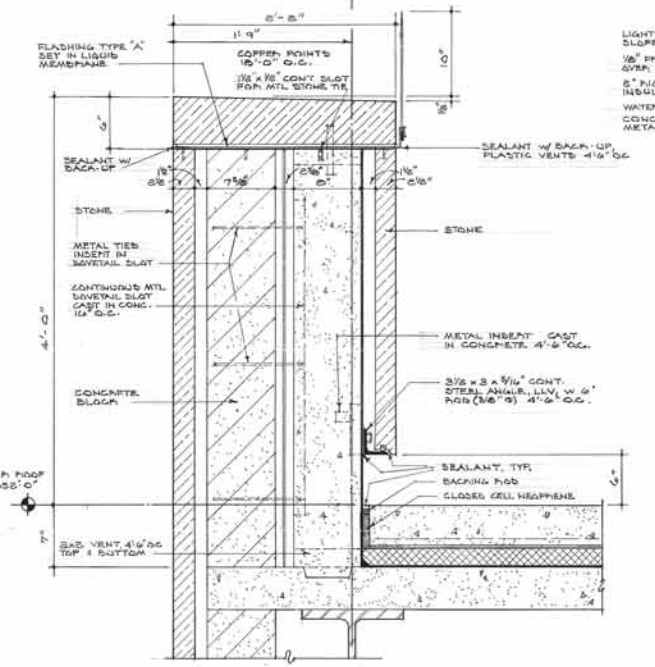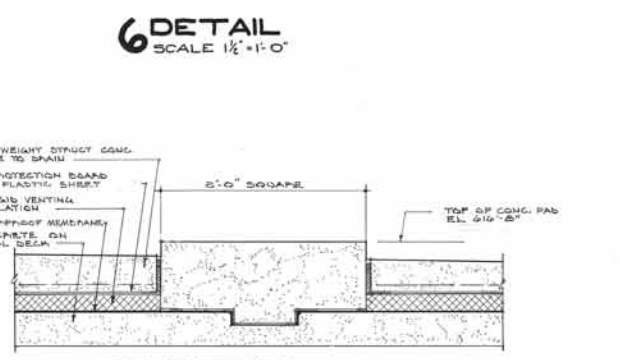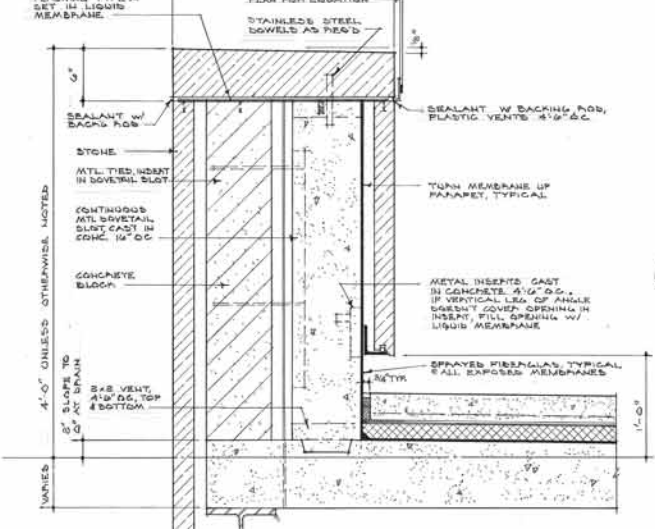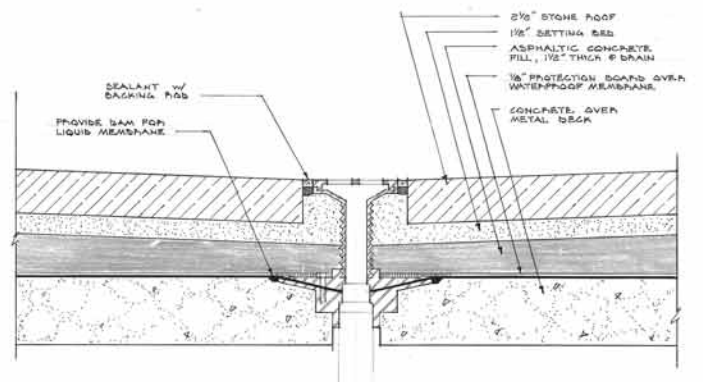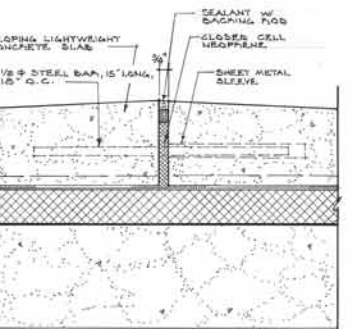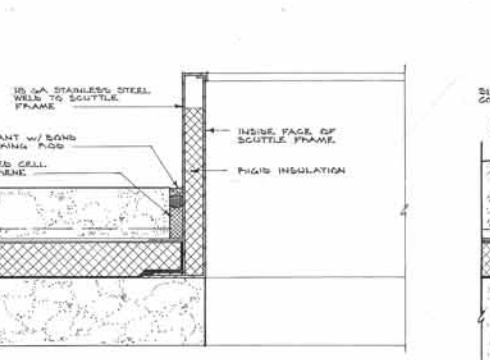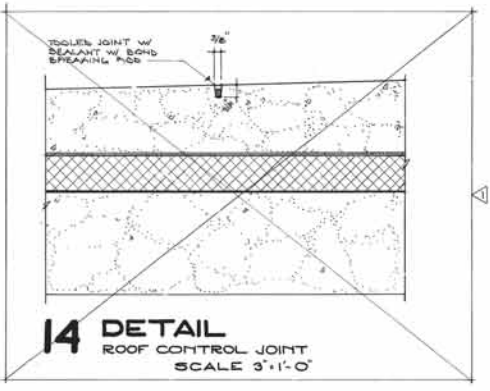

REVISIONS	DATE	ISSUED FOR	DATE
1	ADDITIONAL ITEMS	GENERAL CHECKING	JUNE 1978
2	AUTOMATICALLY	CORRECTED DRAWING	NOV. 1978
3	CONCRETE SPECIFICATIONS		

**DALTON · DALTON · LITTLE AND BRUBAKER/BRANDT, INC.**  
ARCHITECTS  
KORDA & ASSOCIATES, LTD., STRUCTURAL ENGINEERS  
RALPH J. KRAMER, COMER & PASSE, MECHANICAL/ELECTRICAL ENGINEERS

**STATE OFFICE BUILDING AND FACILITIES**  
30-50 EAST BROAD STREET, COLUMBUS, OHIO  
FOR THE **OHIO BUILDING AUTHORITY**  
PREPARED FOR STATE OF OHIO DEPARTMENT OF PUBLIC WORKS

DRAWN BY \_\_\_\_\_ DATE \_\_\_\_\_  
RECORD DRAWING JUN 1, 1978

**A4-19**