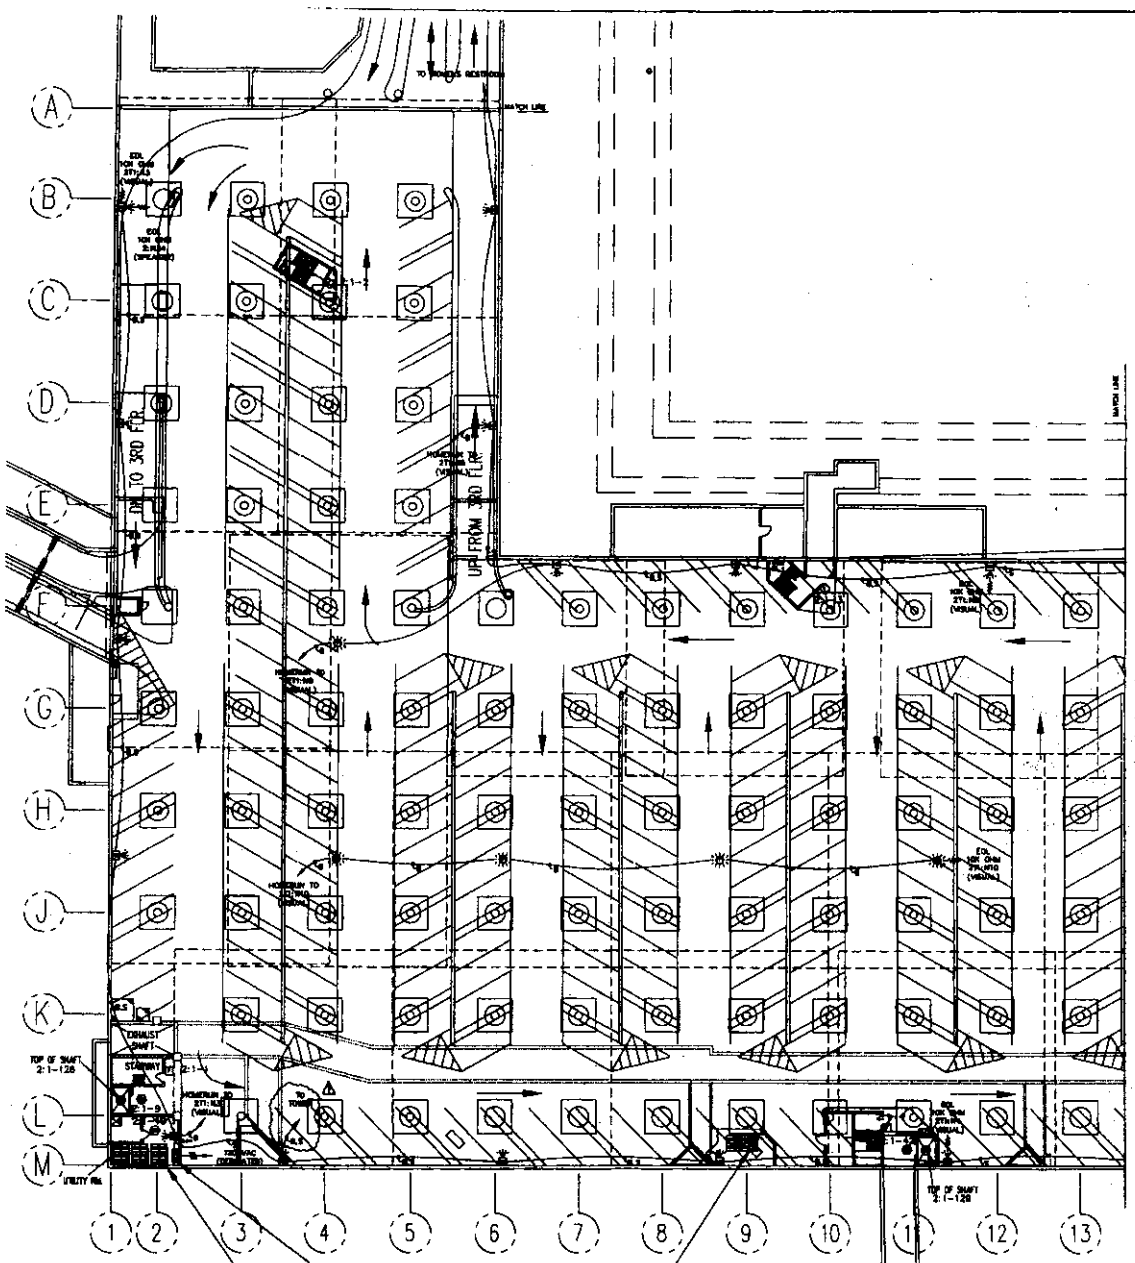

GREEN (UPPER) LEVEL NORTH

ZONE	DEVICE	DESCRIPTION


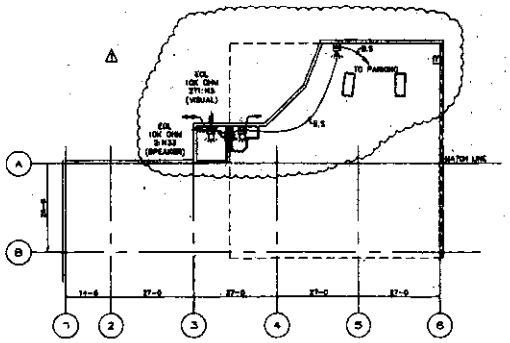

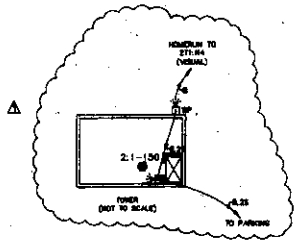

LARRY K. PARTEE
DIVISION OF
FIRE PROTECTION SYSTEM COMPONENT DESIGNER
CERTIFICATION #F-088
VALID THROUGH 1/28/2006

STATE HOUSE PARKING GARAGE - GREEN (UPPER) LEVEL NORTH FLOOR PLAN

Capital Square Review and Advisory
State House Parking Garage
Columbus, Ohio 43215

REV	PROJECT #	DATE	BY	REVISION DESCRIPTION
1	063-04301	5/9/06	LKP	AS BUILT

SCALE: 1/16" = 1'

FA-101

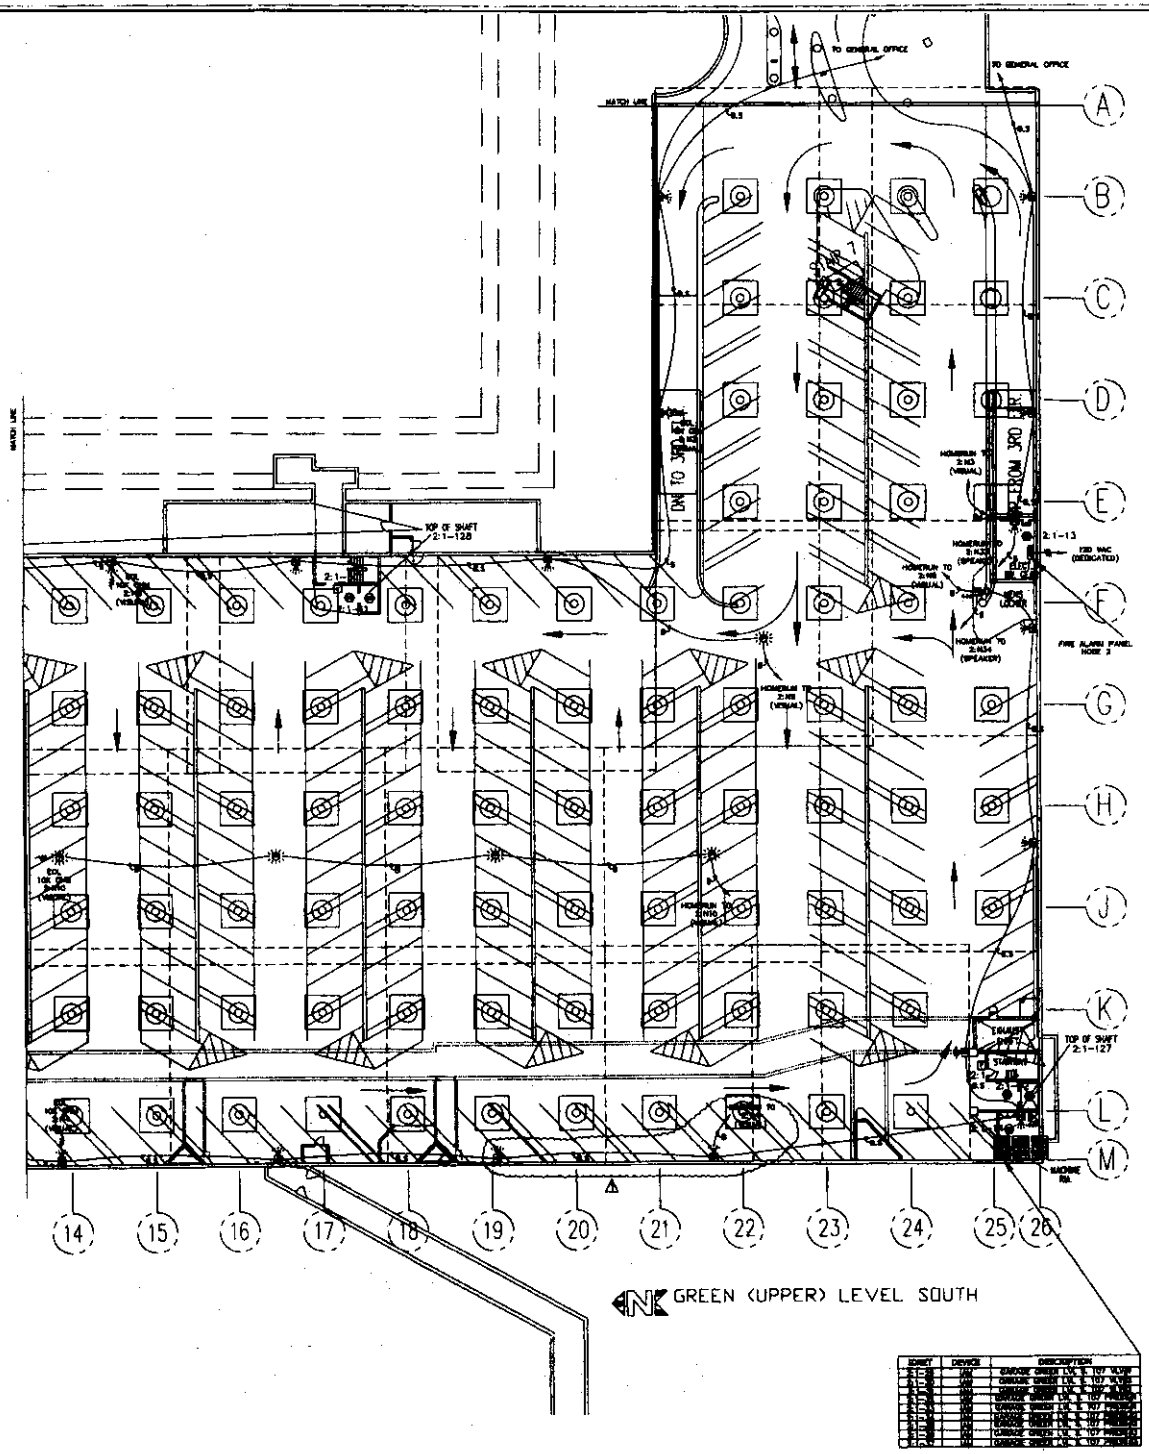

○ CODED NOTES:
1.

GENERAL NOTES:
1. BUILDING IS FULLY SPRINKLED.

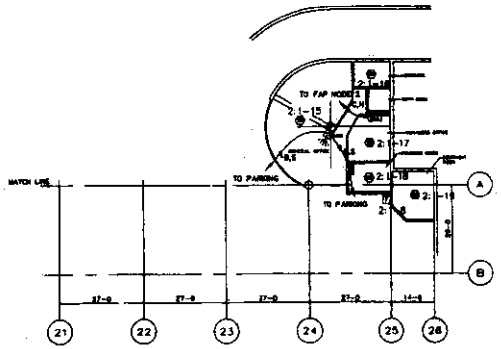

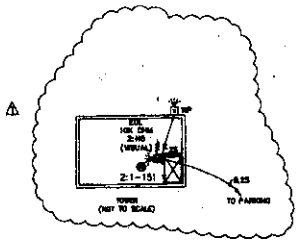

SCHEDULE	DEVICE	DESCRIPTION
[illegible]	[illegible]	GARAGE GREEN LVL S. 107 VLVM
[illegible]	[illegible]	GARAGE GREEN LVL S. 107 VLVM
[illegible]	[illegible]	GARAGE GREEN LVL S. 107 VLVM
[illegible]	[illegible]	GARAGE GREEN LVL S. 107 PRESSURE
[illegible]	[illegible]	GARAGE GREEN LVL S. 107 PRESSURE
LARRY K. PARKER
BUSLIN, OHIO
NICET LEVEL 2B
FIRE PROTECTION SYSTEM COMPONENT DESIGNER
CERTIFICATION #F-[illegible]
VALID THROUGH 1/28/2008

Tyson / Fire & Security / Simplex Grinnell

6175 SHAMROCK COURT
DUBLIN, OH 43016
SUITE E
SALES: 614-[illegible]
SERVICE: 614-[illegible]
FAX: 614-[illegible]

REV	CHECKED	DATE	BY	REVISION DESCRIPTION
1	[illegible]	6/9/08	LKP	AS BUILT

STATE HOUSE PARKING GARAGE - GREEN (UPPER) LEVEL SOUTH FLOOR PLAN

FIRE ALARM SYSTEM

Capital Square Review and Advisory
State House Parking Garage
Columbus, Ohio 43215

DRAWN BY: LKP	SCALE: TCS
CHECKED: LKP	DATE: 10/12/08
SCALE: 1/16" = 1'	
DWG NUMBER: 563-401761	
DRAWING NUMBER: FA-102	

GENERAL NOTES:

1. BUILDING IS FULLY SPRINKLED. GARAGE FAP IS NETWORKED TO THE NEW NETWORK DISPLAY UNIT IN THE HIGHWAY PATROL OFFICE, WHICH IS MONITORED 24 HOURS/DAY.

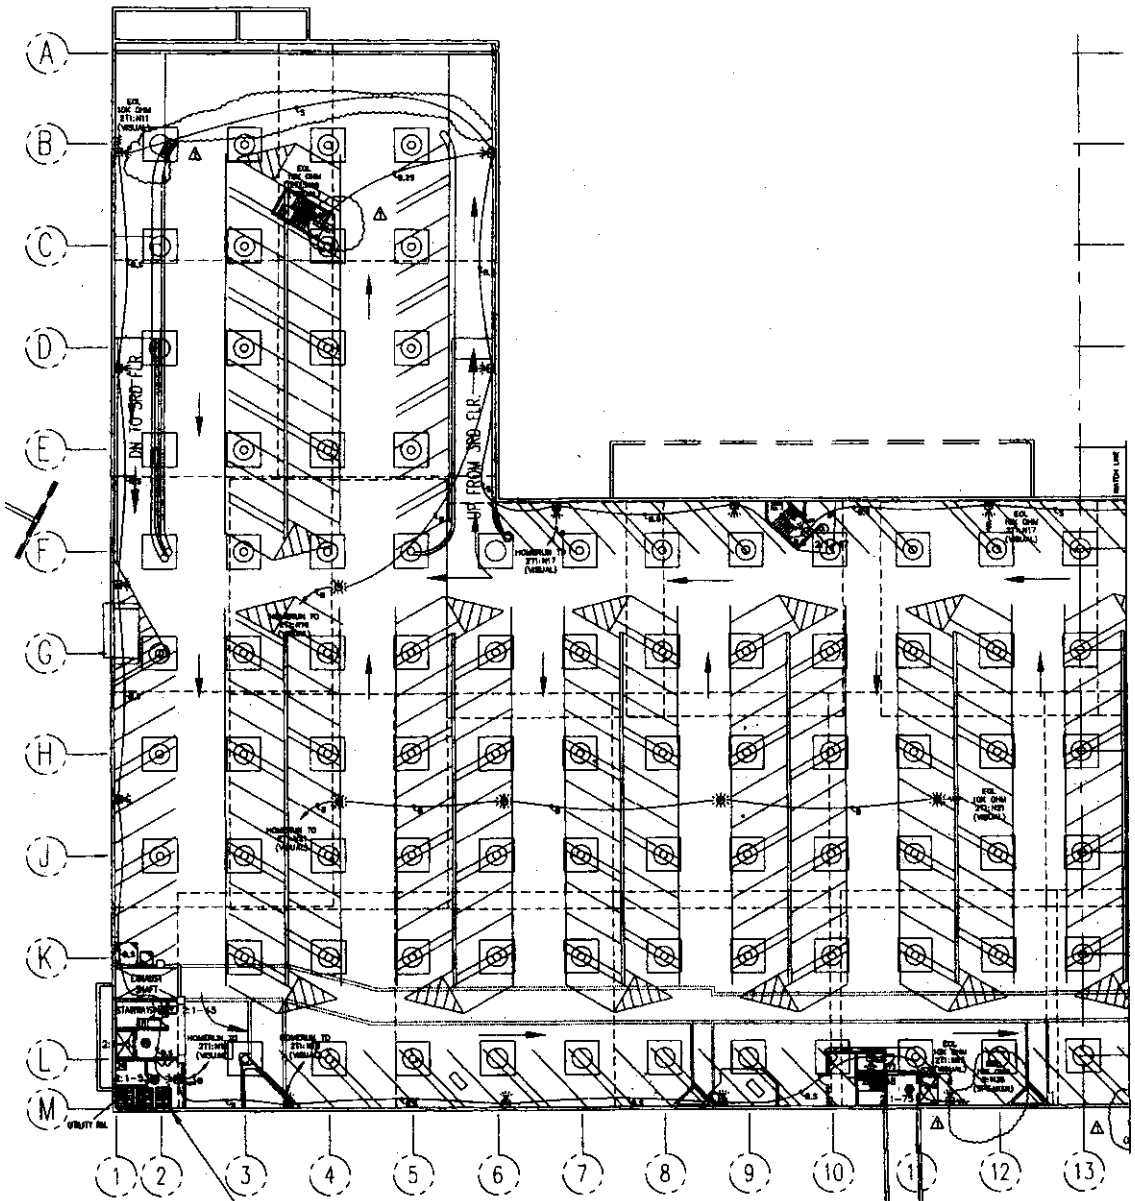

YELLOW (MIDDLE) LEVEL NORTH

ADMIN	DEVICE	DESCRIPTION
[illegible]	LAM	GARAGE YELLOW LVL N. 207 VLVM
[illegible]	LAM	GARAGE YELLOW LVL N. 207 VLVM
[illegible]	LAM	GARAGE YELLOW LVL N. 207 PRESSED
[illegible]	LAM	GARAGE YELLOW LVL N. 207 PRESSED
LARRY K. PARTEE
[illegible]
DUBLIN, OHIO
NICET LEVEL III
FIRE PROTECTION SYSTEM COMPONENT DESIGNER
CERTIFICATION #[illegible]
VALID THROUGH 1/28/2006

tyco | Fire & Security | Simplex Grinnell

REV	PROJECT #	DATE	BY	AS BUILT
1	[illegible]	6/8/05	LMP	

STATE HOUSE PARKING GARAGE - YELLOW (MIDDLE) LEVEL NORTH FLOOR PLAN

FIRE ALARM SYSTEM

Capital Square Review and Advisory

Columbus, Ohio 43215

DRAWN BY: LMP	CHECKED: TEB
APPROVED: LMP	DATE: 10/12/05
SCALE: 1/16" = 1'	
DRAWING NUMBER: 983-401751	
SHEET NUMBER: FA-103	

GENERAL NOTES:

1. BUILDING IS FULLY SPRINKLED. GARAGE FAP IS NETWORKED TO THE NEW NETWORK DISPLAY UNIT IN THE HIGHWAY PATROL OFFICE, WHICH IS MONITORED 24 HOURS/DAY.

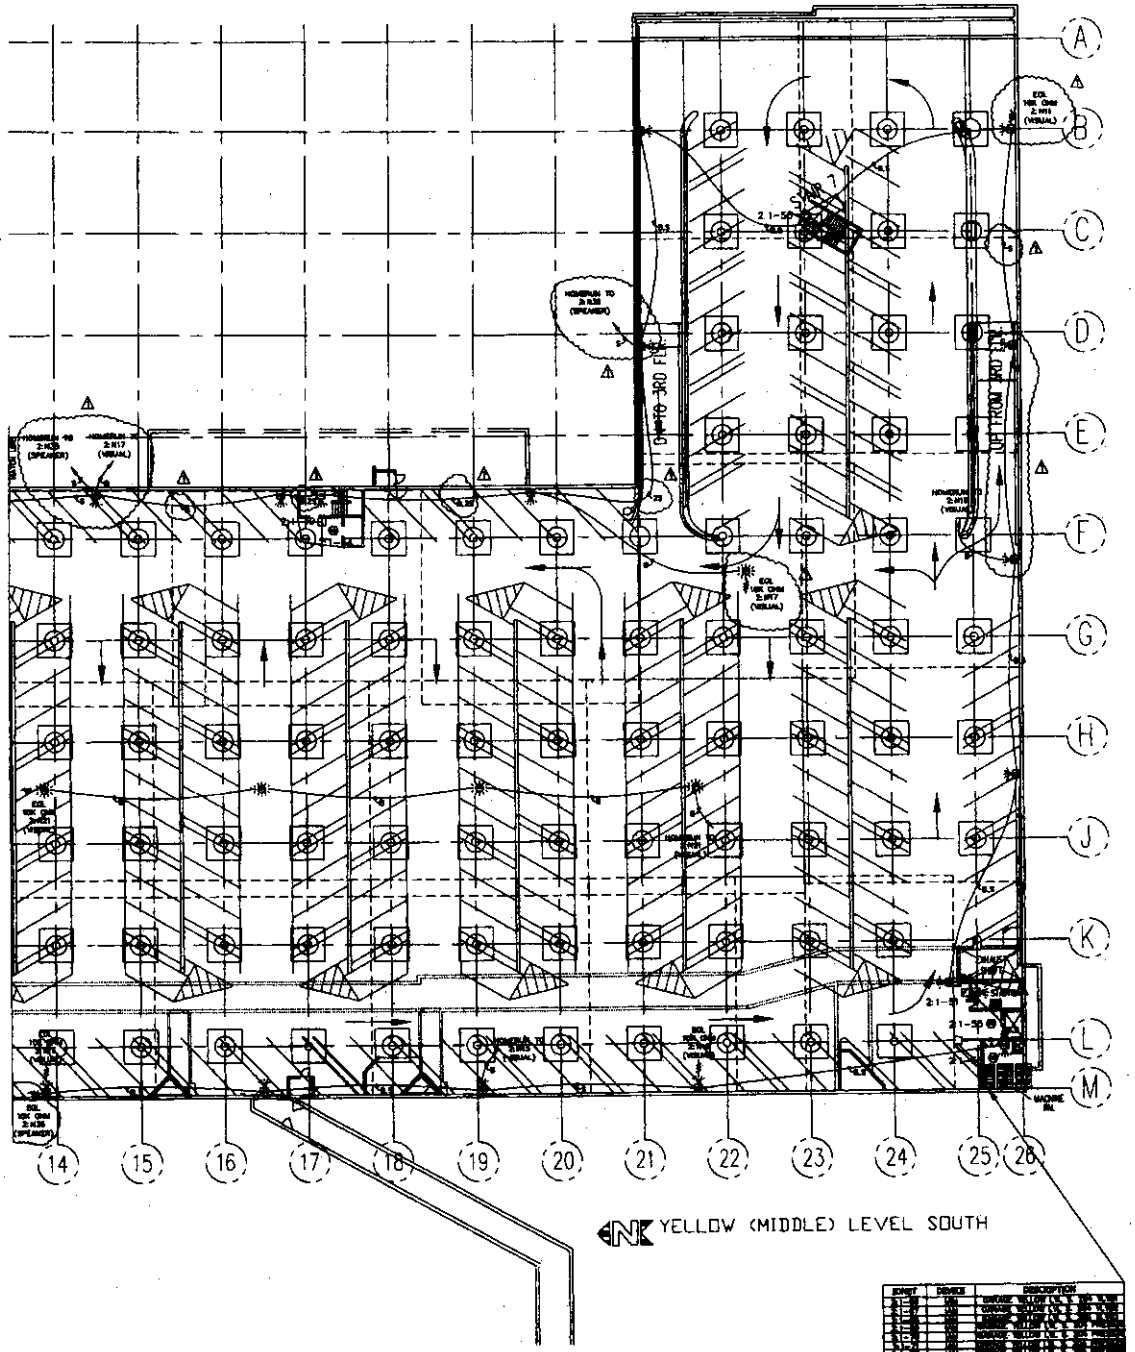


LARRY E. PAYNE
DUBLIN, OHIO
NICET LEVEL IV
FIRE PROTECTION SYSTEM COMPONENT DESIGNER
CERTIFICATION #F-0551
VALID THROUGH 1/30/2005

tyco / Fire & Security / Simplex/Grinnell

REV	ISSUED / REVISION	DATE	BY	CHK	REVISION DESCRIPTION
1	10/24/00	6/6/01	LMP	LMP	AS BUILT

STATE HOUSE PARKING GARAGE - YELLOW (MIDDLE) LEVEL SOUTH FLOOR PLAN
FIRE ALARM SYSTEM

Columbus, Ohio 43215

Capital Square Review and Advisory

DRAWN BY	LMP
CHECKED BY	LMP
DATE	10/12/00
SCALE	1/16" = 1'
SYSTEM NO.	883-4017991
SHEET NUMBER	FA-104

GENERAL NOTES:

1. BUILDING IS FULLY SPRINKLED. GARAGE FAP IS NETWORKED TO THE NEW NETWORK DISPLAY UNIT IN THE HIGHWAY PATROL OFFICE, WHICH IS MONITORED 24 HOURS/DAY.

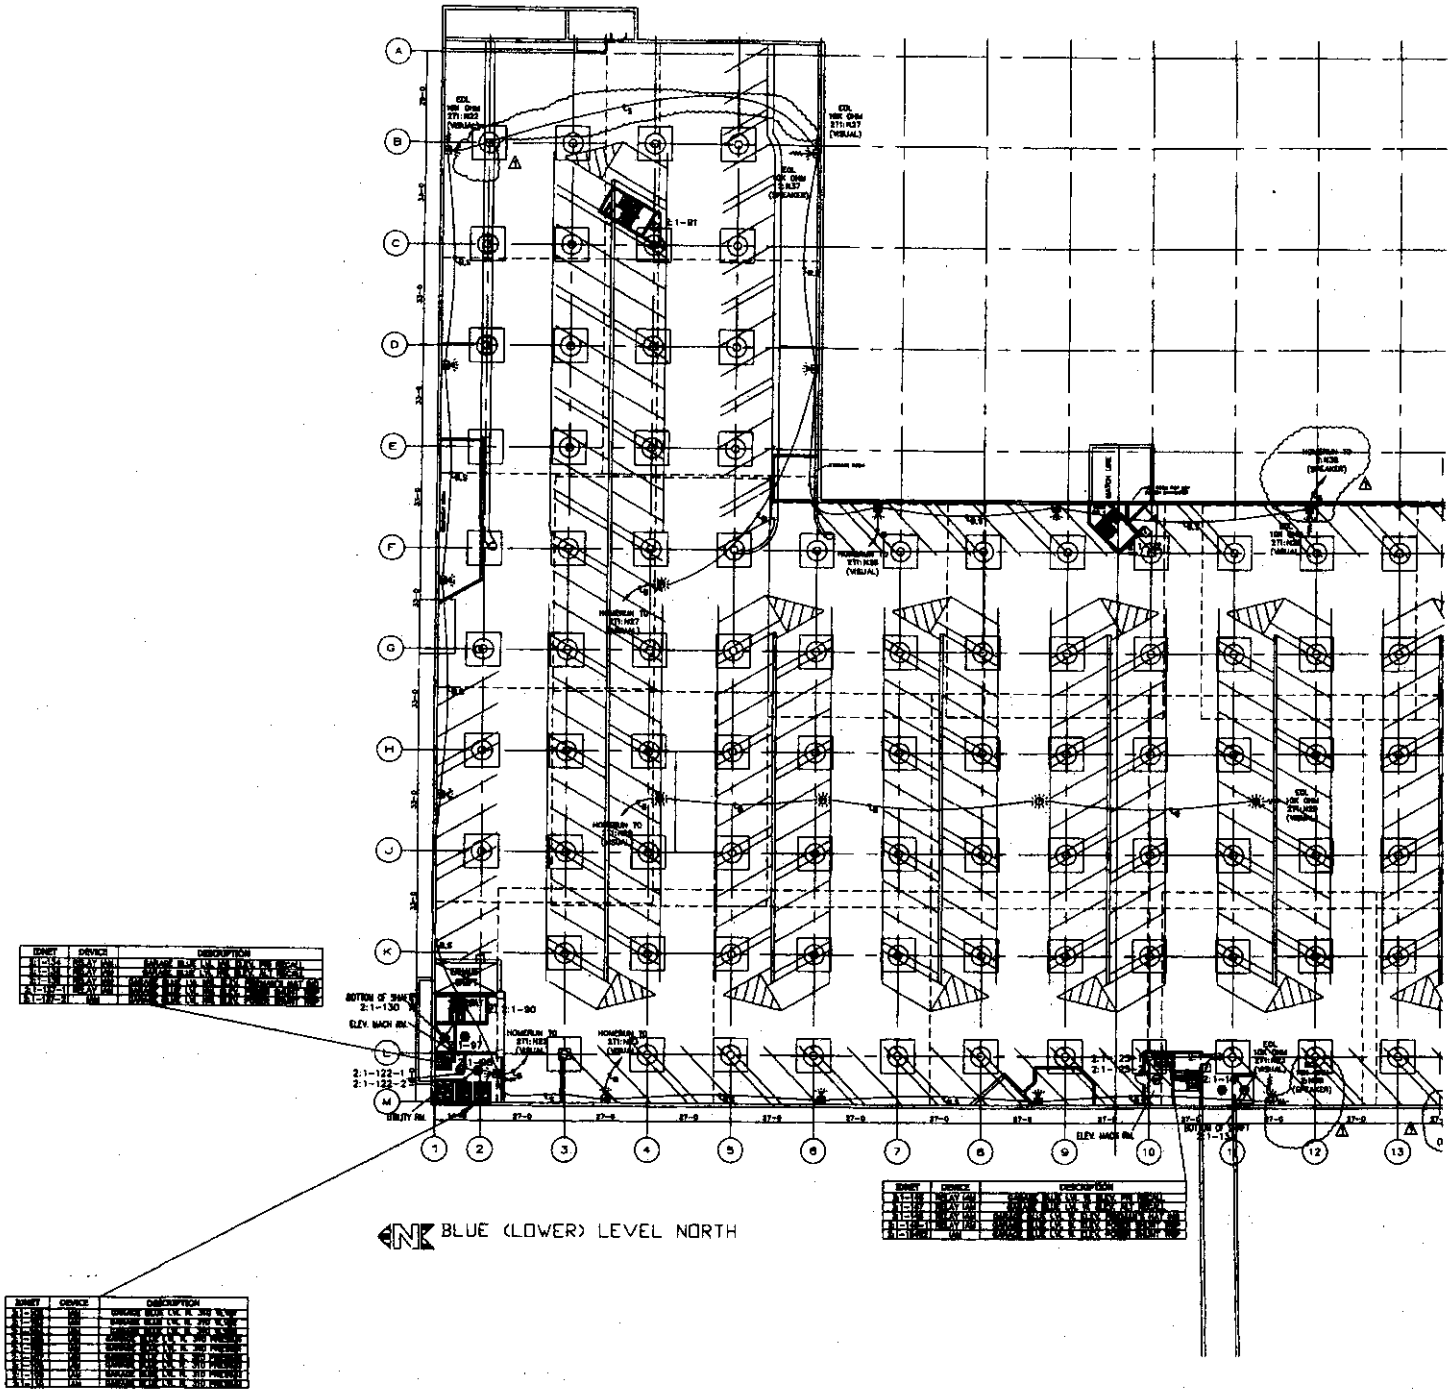


STATE HOUSE PARKING GARAGE - BLUE (LOWER) LEVEL NORTH FLOOR PLAN

FIRE ALARM SYSTEM

Capital Square Review and Advisory

Columbus, Ohio 43215

LARRY E. PARTEE
DIBLIN, OHIO
NICET LEVEL III
FIRE PROTECTION SYSTEM COMPONENT DESIGNER
CERTIFICATION #F-088
VALID THROUGH 1/28/2009

LAP | TCB
LAP | 10/12/05

1/16" = 1'

FA-105

GENERAL NOTES:

1. BUILDING IS FULLY SPRINKLED. GARAGE FAP IS NETWORKED TO THE NEW NETWORK DISPLAY UNIT IN THE HIGHWAY PATROL OFFICE, WHICH IS MONITORED 24 HOURS/DAY.

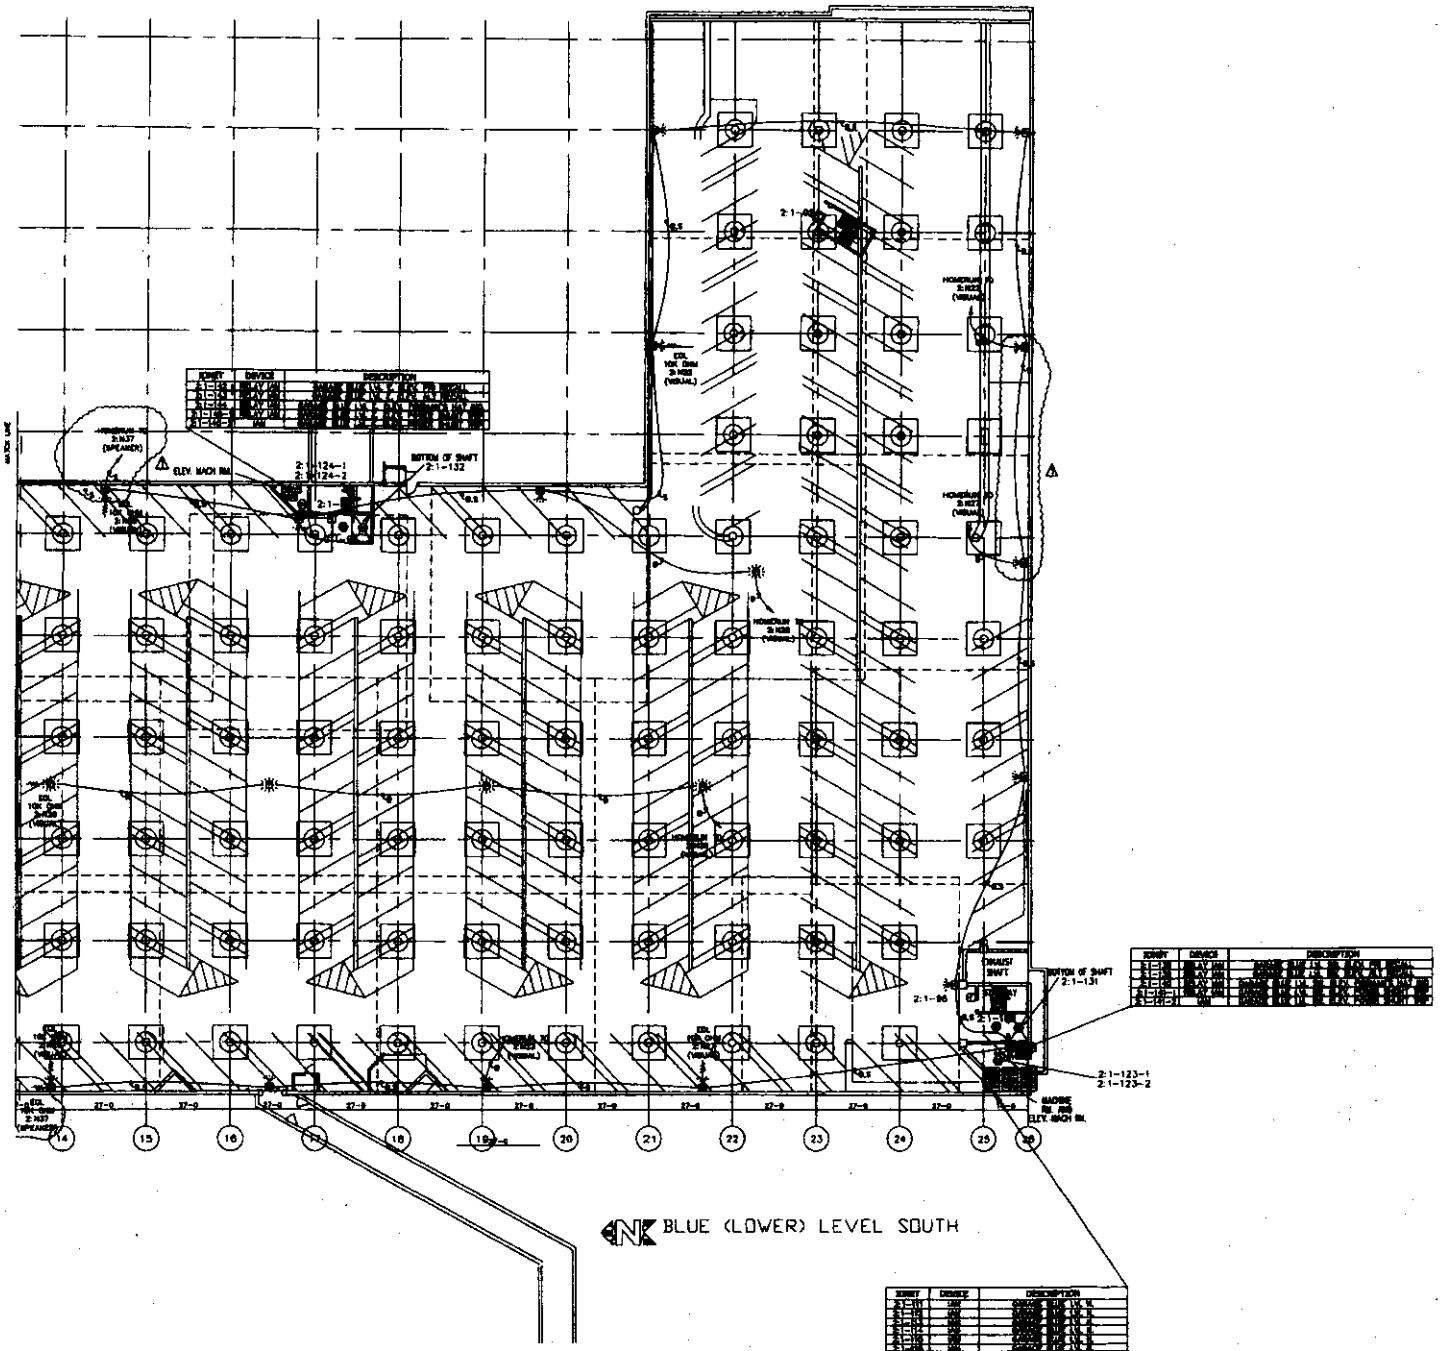

SCHEDULE	DEVICE	DESCRIPTION
[illegible]	[illegible]	[illegible]

SCHEDULE	DEVICE	DESCRIPTION
[illegible]	[illegible]	[illegible]

SCHEDULE	DEVICE	DESCRIPTION
[illegible]	[illegible]	[illegible]

LARRY K. PARTEE
DUBLIN, OHIO
MDET LEVEL III
FIRE PROTECTION SYSTEM COMPONENT DESIGNER
CERTIFICATION #F-055
VALID THROUGH 1/28/2008

tyco | Fire & Security | Simplex Grinnell

STATE HOUSE PARKING GARAGE - BLUE (LOWER) LEVEL SOUTH FLOOR PLAN

FIRE ALARM SYSTEM

Capital Square Review and Advisory
State House Parking Garage
Columbus, Ohio 43215

DRAWN BY: LKP	CHK'D: TEB
DESIGNED: LKP	DATE: 10/12/06
SCALE: 1/16" = 1'	
SITE NUMBER: 863-401781	
SHEET NUMBER: FA-106	